

AGRICULTURAL OPERATIONS & SMALL AGRICULTURAL STORE PLOT PLAN

17054 HANDLEBAR ROAD, RAMONA, CA 92065

APN 278-361-08-00 · ZONE A70 (LIMITED AGRICULTURE)

ZONING BOX: A70 / L / 2AC / C / G / C / C

LEGAL: PARCEL 1 OF PARCEL MAP NO. 5062 · ASSR, BK 278 PG 36 PAR. 8

GROSS AREA: 164,443 SF (3.78 AC) · NET AREA: 157,251 SF (3.61 AC)

OWNER: CORY J. DZBINSKI & CARISSA ULTSCH

17054 HANDLEBAR RD, RAMONA, CA 92065

farmhousegetaways@gmail.com

PREPARED BY: OWNER

AGRICULTURAL USE SUMMARY

| ZONE  | USE / CROP              | AREA      |
|-------|-------------------------|-----------|
| AG-1  | ORCHARD (FRUIT TREES)   | 688 SF    |
| AG-2  | ORCHARD (FRUIT TREES)   | 4,672 SF  |
| AG-3  | ORCHARD (FRUIT TREES)   | 1,814 SF  |
| AG-4  | VINEYARD                | 2,074 SF  |
| AG-6  | PEPPER + NUT TREES      | 2,354 SF  |
| AG-7  | LUFFA + VEGETABLES      | 2,844 SF  |
| AG-8  | VEGETABLES + FLOWERS    | 2,521 SF  |
| AG-9  | ORCHARD 2 (FRUIT TREES) | 17,125 SF |
| AG-10 | FRUIT TREES + PUMPKIN   | 7,530 SF  |
| AG-11 | FRUIT TREES + PUMPKIN   | 8,467 SF  |
| AG-12 | ROSEMARY (HERBS)        | 1,734 SF  |
| BG    | BIRD GARDEN (POULTRY)   | 6,331 SF  |

TOTAL ACTIVE AGRICULTURAL AREA 58,154 SF

= 35.4% OF GROSS (ZO §6157.a.2.b.ii REQ.: 25% = 41,111 SF)

AREA USABLE FOR AGRICULTURE 137,151 SF

= 83.4% OF GROSS (ZO §6157.a.2.b.i REQ.: 50% = 82,222 SF)

AG-5 NOT USED (NUMBERING PER OWNER FIELD NOTES). AREAS TO SCALE, NOTE 2.

STRUCTURE SUMMARY

| STRUCTURE / USE                                                            | STATUS        | AREA     |
|----------------------------------------------------------------------------|---------------|----------|
| MINI BARN MARKET — SMALL AG. STORE 12'x10'                                 | AS-BUILT      | 110 SF   |
| STORAGE BLDG 10'x10' (ADJ. TO STORE — NO SALES)                            | EXISTING      | 100 SF   |
| CUSTOMER PARKING, 6 SPACES                                                 | PROPOSED      | 1,116 SF |
| † BARN — STORAGE 50'x44'                                                   | EXISTING      | 2,200 SF |
| SFD — RESIDENCE (48R/28A)                                                  | EXISTING      | 2,700 SF |
| † GARAGE / ACCESSORY BLDG, 2 STORY                                         | EXISTING      | 1,600 SF |
| † POULTRY COOP                                                             | EXISTING      | 50 SF    |
| POOL                                                                       | EXISTING      | 1,380 SF |
| TINY HOME (W)                                                              | TO BE REMOVED | 240 SF   |
| † DETACHED ACCESSORY STRUCTURES, ZO §6156.g (4,000 SF ALLOWED, 2-4 AC LOT) |               | 3,850 SF |

AREAS INSIDE WALLS (OWNER). UNMARKED: STORE (§6157 USE), RESIDENCE, POOL, PARKING.

NOTES

- PARCEL BOUNDARY PER COUNTY GIS, OWNER-VERIFIED AGAINST THE SITE AERIAL; BEARINGS AND DISTANCES ON THE DRAWING ARE GIS-DERIVED. RECORD BEARINGS, DISTANCES AND AREA PER PM 5062; SEE 'BOUNDARY & RECORD DATA'; DIMS IN FEET.
- AG AREAS AND STRUCTURE FOOTPRINTS AERIAL-DERIVED. FIELD-CORROBORATED, AND PER OWNER MEASUREMENT WHERE STATED (STORE 12'x10', STORAGE 10'x10', BARN 50'x44'). EACH CROP AREA IS DRAWN INSIDE THE PROPERTY LINES, CLEAR OF THE DRIVEWAY AND STRUCTURES, AND SCALES TO THE AREA TABULATED FOR IT — THE DRAWING AND THE TABLE AGREE. AG-3 STOPS AT THE FENCE — 20' W OF SEPTIC; AG-9 LEGS MEASURED 200' (W), 130' (N), 190' (E FENCE); W AND N SIDES CURVE OUT.
- NO GRADING OR NEW CONSTRUCTION PROPOSED; THE 12'x10' STORE IS AS-BUILT. PLAN DOCUMENTS EXISTING AG OPERATIONS + THE AS-BUILT SMALL AG. STORE (ZO §6157).
- SETBACKS PER ZO §4810 SCHEDULE C (DESIGNATOR C). FRONT YARDS 60'; FROM THE EAST P.L., AND 5 OF THE BEND FROM WHIRLWIND LN, 30' W OF THE WEST P.L. (60' ROAD; THE W P.L. IS ITS EAST EDGE). N OF THE BEND: EXTERIOR SIDE YARD, GREATER OF 33' FROM, OR THE 15' INT. SIDE YARD (PDS-306 P.5) — 15' OFF THE ESMT. N/S INTERIOR SIDE YARDS 15'; NO REAR YARD — LOT FRONTS STREETS E + W.
- THE AS-BUILT STORE SITS N OF THE WHIRLWIND BEND, CLEAR OF EVERY REQUIRED YARD (41' FROM THE ROAD EDGE, 71' FROM ITS, 470' FROM THE EAST P.L.). EXIST. TINY HOME (W) IS TO BE REMOVED. WHIRLWIND, IS APPROXIMATE PENDING PM 05062.
- POND IS RUNOFF-FED (NO PUMP); IRRIGATION SOURCE & AREA OF INUNDATION; LOT DRAINS TO POND, WELL, SEPTIC AND LEACH LINES PER OWNER, APPROXIMATE.
- THE GREENHOUSE AND TRELLIS GARDEN ARE OPEN AG STRUCTURES WITHIN THE CROP AREAS AND ARE TABULATED AS BUILDING AREA; THEIR GROUND IS COUNTED IN AG-7. ELECTRICAL: 400A MAIN PANEL AT THE NE COR. OF THE STORAGE BLDG.
- DRIVEWAY RUNS FROM THE STORE/PARKING YARD S BETWEEN AG-1 AND AG-4, E BETWEEN AG-4 AND THE BARN AND PAST THE RESIDENCE, THEN SE BETWEEN AG-9 AND AG-12, LEAVING THE PARCEL NEAR THE SE CORNER AND CONTINUING ±700' TO HANDLEBAR RD VIA AN ACCESS ESMT. ACROSS THE ADJACENT PARCEL. GRAVEL BOTH ENDS, DIRT MID-SEGMENT, 12' WIDE; SLOPE 2% DRAINING W. NO OTHER ROAD CROSSES THE PARCEL. ALIGNMENT TRACED FROM THE SITE AERIAL.
- WHIRLWIND LN IS A 60' ROAD. THE WEST P.L. IS ITS EAST EDGE, ON THE EXIST. WEST FENCE; ITS, 4 IS 30' W OF THAT LINE (OWNER-MEASURED FENCE TO, ± 30'). N OF THE BEND IT CROSSES THE NW CORNER, HANDLEBAR RD OFF-SITE (NOTE 8). PM 05062 TBD.
- NO NEW OR MODIFIED LANDSCAPE AREA PROPOSED (PDS 090 ITEM 16). EXISTING AG, PERIMETER AND POOL FENCING AND GATES ONLY; ALL ARE 6'-0" OR LESS IN HEIGHT PER OWNER — NO BLDG. PERMIT REQ'D PER PDS 070.
- THE SMALL AGRICULTURAL STORE IS THE AS-BUILT 'MINI BARN MARKET', A 12'x10' BUILDING, 110 SF INSIDE WALLS — WELL UNDER THE 1,500 SF LIMIT OF §6157.a.2 + INCL. OPEN ROOFED DISPLAY (NONE). THE ADJACENT 10'x10' BLDG IS STORAGE ONLY; NO OTHER STRUCTURE WILL BE USED FOR ON-SITE SALES. PUBLIC-ACCESSED AREAS TO BE PERMITTED TO COMM. BLDG. CODE AND DEHQ REQUIREMENTS.
- ACCESSIBLE STALL, AISLE AND THE ROUTE TO THE STORE ENTRANCE TO BE A STABLE, FIRM, SLIP-RESISTANT SURFACE PER CBC CH. 11B AND §6157.a.2.h.

AGRICULTURAL OPERATIONS & SMALL AGRICULTURAL STORE

PLOT PLAN — EXISTING CONDITIONS & AS-BUILT STORE

17054 HANDLEBAR RD, RAMONA, CA 92065

APN 278-361-08-00 · ZONE A70

SCALE: 1" = 40'

DATE: 8/06/2026

SHEET 1 OF 2 · REV 41


REV DATE DESCRIPTION

4-6 8/06-8/19 BASE, SETBACKS, FARM STORE

7-16 8/21/2026 OWNER CORRECTION ROUNDS

17-32 8/22-9/15 RECORD DATA, SETBACKS, AS-BUILT

33-40 9/15-9/16 WHIRLWIND; AG-6; §6156 AREAS

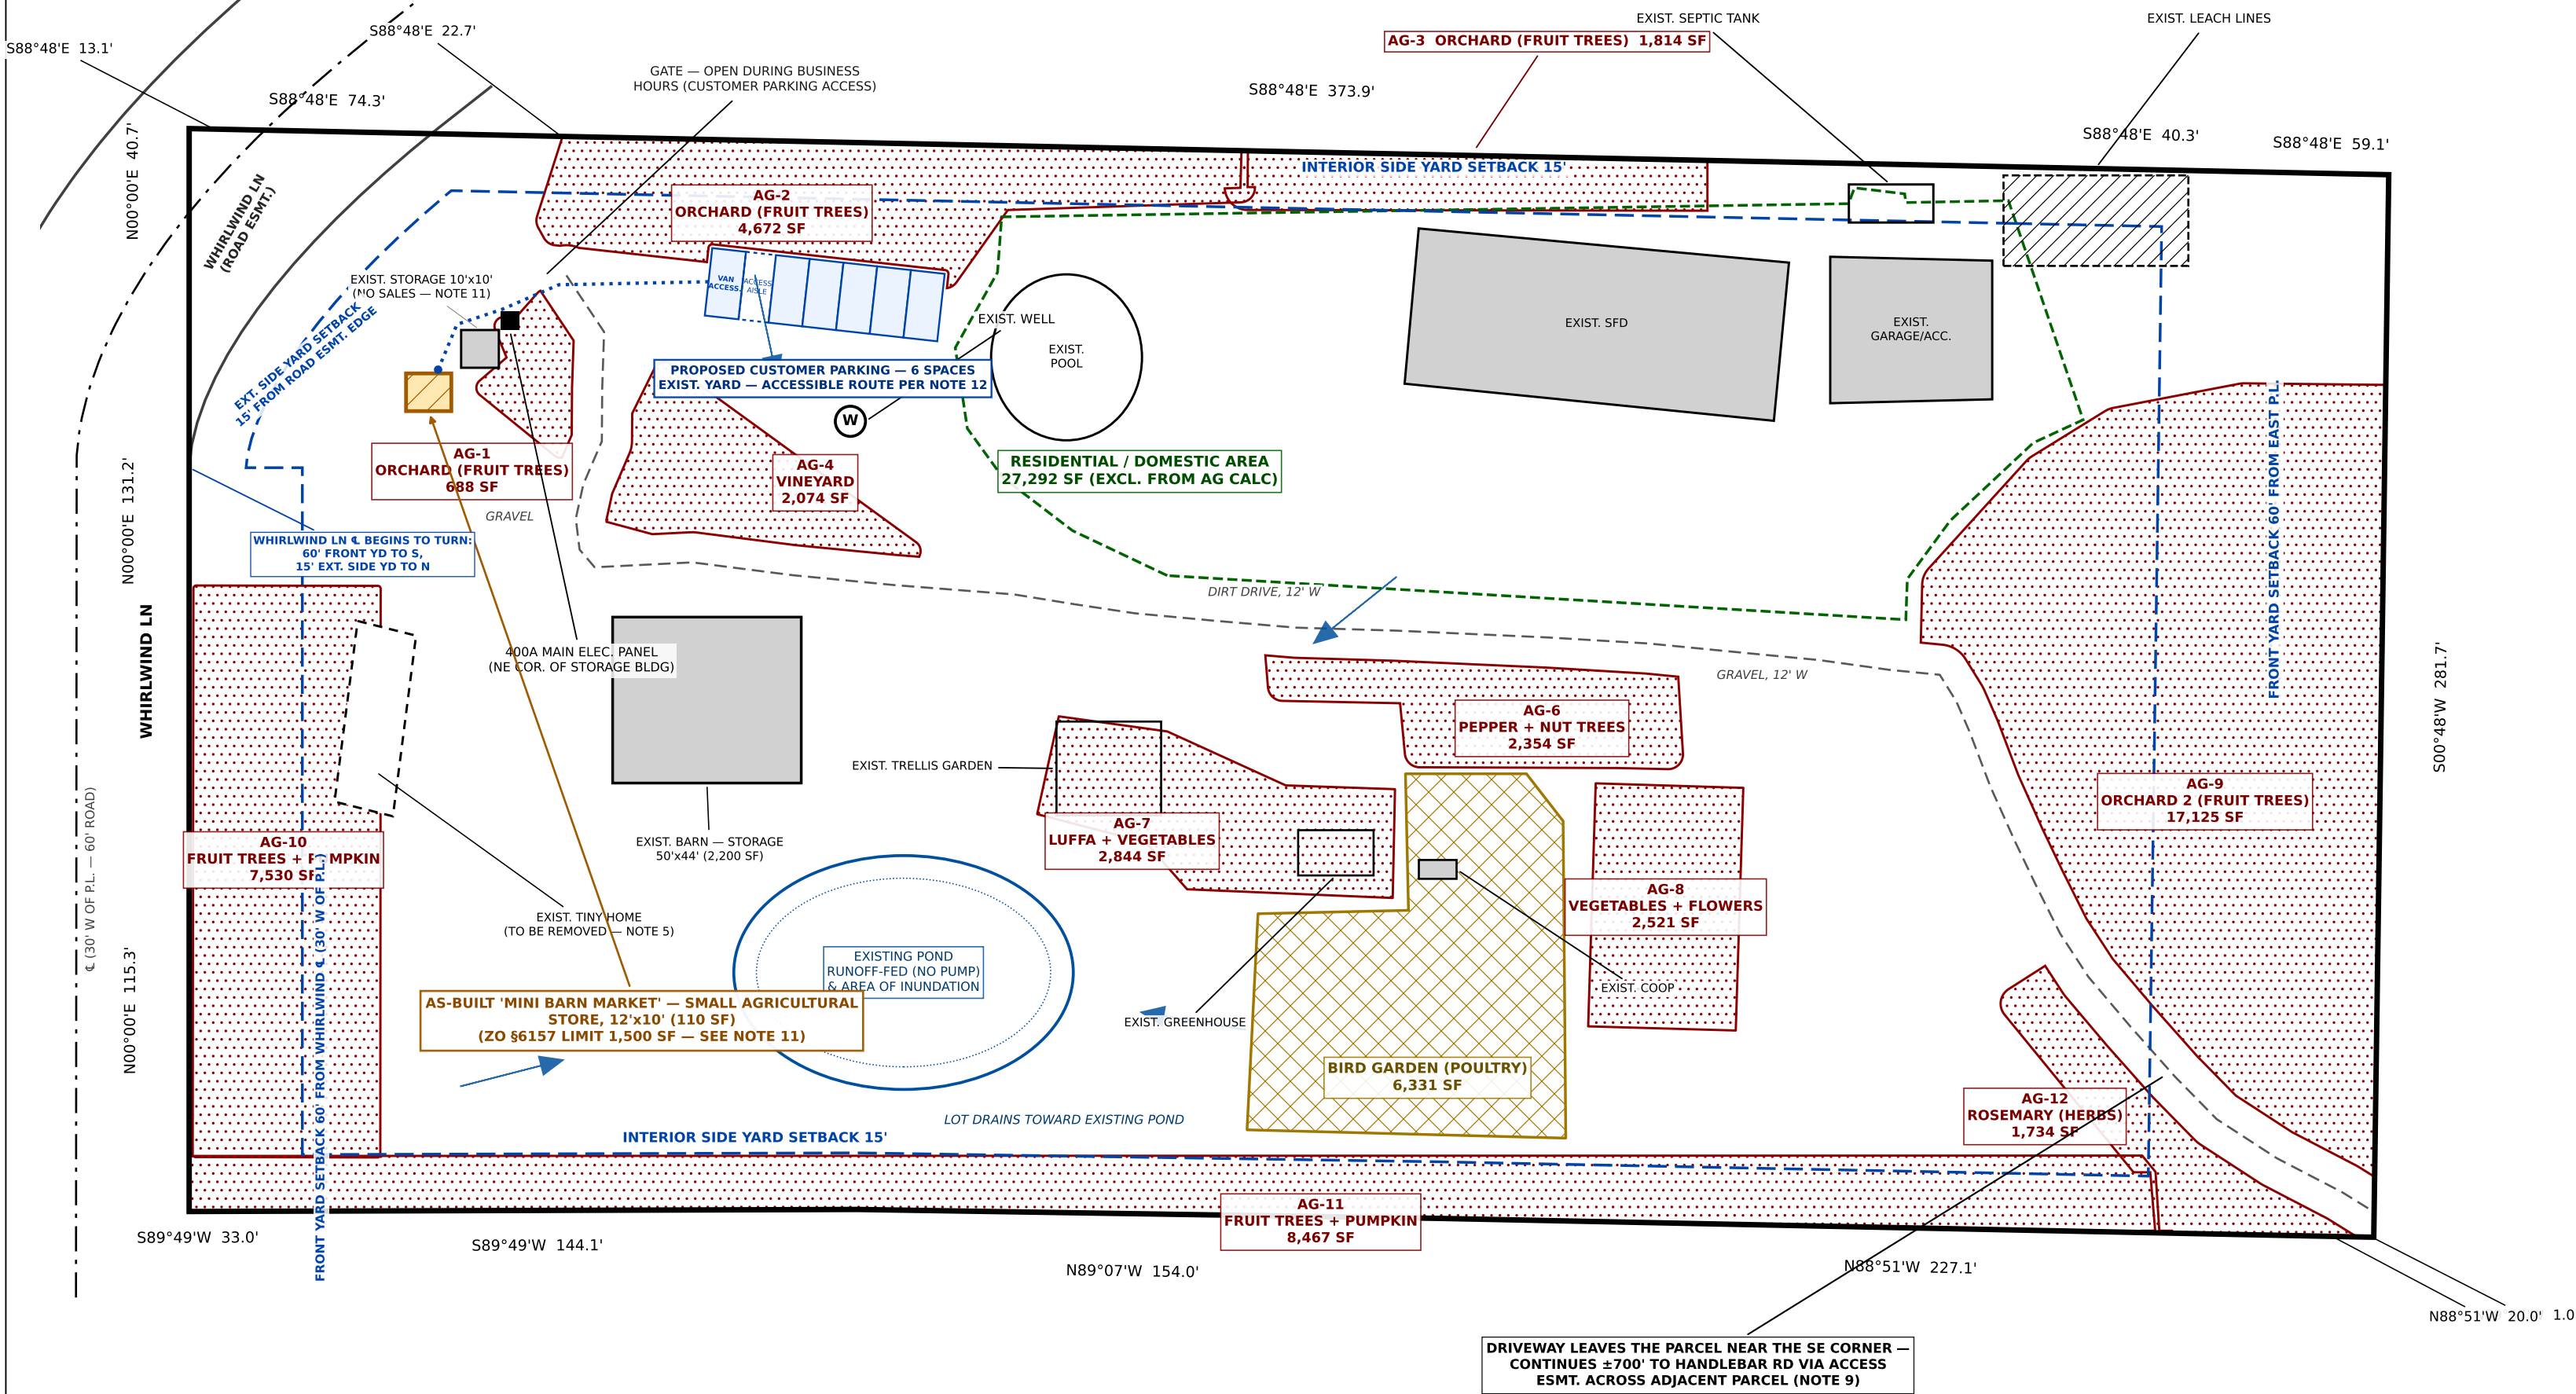

AGRICULTURAL USE CALCULATION

PER ZO §6157.a.2.b — GROSS BASIS

TOTAL GROSS AREA OF PREMISES 164,443 SF

b.i REQUIRED 50% SUITABLE / AVAILABLE 82,222 SF

PROVIDED (GROSS LESS RESIDENTIAL) 137,151 SF

= 83.4% OF GROSS PASSES

b.ii REQUIRED 25% IN ACTIVE AG USE 41,111 SF

CROP AREAS AG-1 THRU AG-12 51,823 SF

POULTRY (BIRD GARDEN) 6,331 SF

PROVIDED TOTAL ACTIVE AG USE 58,154 SF

= 35.4% OF GROSS PASSES

MARGIN OVER THE 25% REQUIREMENT +17,043 SF

BOTH ZO §6157.a.2.b THRESHOLDS ARE MET

NET AREA EXCL. ROAD ESMTS. (PDS 090 ITEM 12): 157,251 SF

ON THE NET BASIS AG USE IS 37.0% — MET EITHER WAY.

SMALL AGRICULTURAL STORE

COMPLIANCE — ZONING ORDINANCE §6157.a.2

(ZO UPDATE 102, PUBLISHED 3-26-2020)

§6157C COMMERCIAL AG MUST BE THE PRINCIPAL USE SEE b.i / b.ii

a PERMITTED IN A70 USE REGS. A70 — NO MIN. LOT SIZE

NO ZONING VERIFICATION PERMIT REQ'D PERMITTED BY RIGHT

b.i ≥50% OF GROSS SUITABLE/AVAILABLE 83.4% PROVIDED

b.ii ≥25% OF GROSS IN ACTIVE AG USE 35.4% PROVIDED

c OPERATED BY OWNER OR TENANT OWNER-OPERATED

d ONE STORE PER LEGAL LOT; NO EXIST. NONE EXISTING

AG STAND OR LARGE AG STORE

e STORE ≤1,500 SF INCL. ROOFED DISPLAY 110 SF — COMPLIES

CONFORM TO §4810 SETBACKS STORE CLEARS ALL YARDS

f PUBLIC AREAS TO COMM. BLDG. CODE + DEHQ SEE NOTE 11

g RETAIL ONLY WITH ON-SITE PRODUCE / EGGS; ACKNOWLEDGED

AG WEIGHTS & MEASURES REGS. APPLY

h ≤200 SF FOR OFF-SITE PRODUCTS TO BE DESIGNATED

i MINIMUM 6 PARKING SPACES 6 SHOWN, GRAVEL

j DISABLED ACCESS PER CBC CH. 11B 1 VAN ACCESSIBLE

k HOURS 10 A.M. TO LEGAL SUNSET ACKNOWLEDGED

l ONE ON-PREMISE SIGN, MAX 4 SF ACKNOWLEDGED

m EVENTS PROHIBITED ACKNOWLEDGED

STORE AREA SUMMARY

STORE = AS-BUILT 'MINI BARN MARKET' BLDG 12'x10' 110 SF

OPEN ROOFED DISPLAY AREA 0 SF

TOTAL PER §6157.a.2.e — LIMIT 1,500 SF 110 SF

PARKING — ZO §6157.a.2.h

REQUIRED 6 SPACES

PROVIDED 6 SPACES

STANDARD 9' x 18' 5

VAN ACCESSIBLE 9' x 18' + 8' AISLE 1

SURFACE — GRAVEL (EXPRESSLY ALLOWED) EXISTING

THE STORE IS THE AS-BUILT 12'x10' MINI BARN MARKET BUILDING —

110 SF AGAINST A 1,500 SF LIMIT. THE ADJACENT 10'x10'

BUILDING IS STORAGE ONLY — NO SALES.

LEGEND

AS-BUILT STORE ('MINI BARN MARKET' 12'x10')

PROPOSED CUSTOMER PARKING

AGRICULTURAL CROP AREA

POULTRY AREA (BIRD GARDEN)

RESIDENTIAL / DOMESTIC AREA

EXISTING STRUCTURE

STRUCTURE TO BE REMOVED

LEACH LINES

ROAD CENTERLINE

ROAD EASEMENT LINE

REQUIRED YARD SETBACK

DRIVEWAY CENTERLINE

DIRECTION OF LOT DRAINAGE

EXISTING WELL

STORMWATER (PDS 272)

NO GRADING OR CLEARING PROPOSED. THE AS-BUILT 12'x10' STORE

(110 SF) IS THE ONLY ADDED IMPERVIOUS AREA; UNDER PERMIT THRESHOLDS.

SD-B: RUNOFF DIRECTED TO PERVIOUS/LANDSCAPED AREAS.

SD-G: EXISTING NATURAL SWALES AND POND CONSERVED.

SD-H: VEGETATED BUFFER MAINTAINED AROUND EXISTING POND.

VICINITY MAP

(NOT TO SCALE)

HIGHLAND VALLEY RD

GARJAN LN

WHIRLWIND LN

SITE 17054 HANDLEBAR RD

APN 278-361-08-00

DRIVEWAY / ACCESS ESMT. ±700'

RAMONA, SAN DIEGO COUNTY, CALIFORNIA

BOUNDARY & RECORD DATA

LEGAL: PARCEL 1 OF PARCEL MAP NO. 5062

ASSESSOR'S MAP BK 278, PG 36, SHT 1, PARCEL 8

| COURSE | RECORD PER PM 5062 | MEASURED (GIS)   |
|--------|--------------------|------------------|
| NORTH  | N89°32'W 550.50'   | S88°48'E 583.25' |
| EAST   | N00°43'E 285.58'   | S00°48'W 281.71' |
| SOUTH  | N89°32'W 550.50'   | N89°20'W 579.19' |
| WEST   | N00°43'E 285.58'   | N00°00'E 287.11' |

AREA RECONCILIATION

RECORD 550.50' x 285.58' 157,212 SF (3.61 AC)

ASSESSOR'S NET AREA (PDS 090 ITEM 12) 157,251 SF (3.61 AC)

COUNTY GIS POLYGON — AREA DRAWN 164,443 SF (3.78 AC)

DIFFERENCE (GIS LESS RECORD) 7,231 SF

THE GIS POLYGON IS 32.75' WIDER E-W THAN RECORD; THAT

STRIP IS THE 30' ROAD ESMT. ALONG THE WEST BOUNDARY

— I.E. THE COUNTY'S OWN GROSS / NET SPLIT.

ZO §6157 TESTS ARE APPLIED TO THE LARGEST (GROSS)

AREA — THE MOST CONSERVATIVE BASIS. THE PARCEL PASSES

ON GROSS (35.1%) AND ON THE RECORD PARCEL (36.7%).

BASIS OF BEARINGS: GRID BEARINGS, NAD83 CALIFORNIA

STATE PLANE ZONE 6, PER COUNTY GIS. RECORD BEARINGS AND

DISTANCES PER PM 5062 / ASSESSOR'S MAP AS TABLED ABOVE.

ADJOINING PARCELS: EAST — APN 278-361-10-00. SOUTH —

APN 278-361-06/07/09-00. WEST — WHIRLWIND LN, THEN APN

278-361-02/03/04-00. NORTH — ASSESSOR'S BK 277, PG 12.