

AGRICULTURAL OPERATIONS & SMALL AGRICULTURAL STORE PLOT PLAN

17054 HANDLEBAR ROAD, RAMONA, CA 92065

APN 278-361-08-00 · ZONE A70 (LIMITED AGRICULTURE)

ZONING BOX: A70 / L / 2AC / C / G / C / C

LEGAL: PARCEL 1 OF PARCEL MAP NO. 5062 · ASSR, BK 278 PG 36 PAR. 8

GROSS AREA: 164,443 SF (3.78 AC) · NET AREA: 157,251 SF (3.61 AC)

OWNER: CORY J. DZBINSKI & CARISSA ULTSCH

17054 HANDLEBAR RD, RAMONA, CA 92065

farmhousegetaways@gmail.com

PREPARED BY: OWNER

AGRICULTURAL USE SUMMARY

ZONE	USE / CROP	AREA
AG-1	ORCHARD (FRUIT TREES)	688 SF
AG-2	ORCHARD (FRUIT TREES)	4,672 SF
AG-3	ORCHARD (FRUIT TREES)	1,814 SF
AG-4	VINEYARD	2,074 SF
AG-6	PEPPER + NUT TREES	2,354 SF
AG-7	LUFFA + VEGETABLES	2,844 SF
AG-8	VEGETABLES + FLOWERS	2,521 SF
AG-9	ORCHARD 2 (FRUIT TREES)	17,125 SF
AG-10	FRUIT TREES + PUMPKIN	7,530 SF
AG-11	FRUIT TREES + PUMPKIN	8,467 SF
AG-12	ROSEMARY (HERBS)	1,734 SF
BG	BIRD GARDEN (POULTRY)	6,331 SF

TOTAL ACTIVE AGRICULTURAL AREA 58,154 SF

= 35.4% OF GROSS (ZO §6157.a.2.b.ii REQ.: 25% = 41,111 SF)

AREA USABLE FOR AGRICULTURE 137,151 SF

= 83.4% OF GROSS (ZO §6157.a.2.b.i REQ.: 50% = 82,222 SF)

AG-5 NOT USED (NUMBERING PER OWNER FIELD NOTES). AREAS TO SCALE, NOTE 2.

STRUCTURE SUMMARY

STRUCTURE / USE	STATUS	AREA
MINI BARN MARKET — SMALL AG. STORE 12'x10'	AS-BUILT	110 SF
STORAGE BLDG 10'x10' (ADJ. TO STORE — NO SALES)	EXISTING	100 SF
CUSTOMER PARKING, 6 SPACES	PROPOSED	1,116 SF
† BARN — STORAGE 50'x44'	EXISTING	2,200 SF
SFD — RESIDENCE (48R/28A)	EXISTING	2,700 SF
† GARAGE / ACCESSORY BLDG, 2 STORY	EXISTING	1,600 SF
† POULTRY COOP	EXISTING	50 SF
POOL	EXISTING	1,380 SF
TINY HOME (W)	TO BE REMOVED	240 SF

† DETACHED ACCESSORY STRUCTURES, ZO §6156.g (4,000 SF ALLOWED, 2-4 AC LOT) 3,850 SF

AREAS INSIDE WALLS (OWNER). UNMARKED: STORE (§6157 USE), RESIDENCE, POOL, PARKING.

NOTES

- PARCEL BOUNDARY PER COUNTY GIS, OWNER-VERIFIED AGAINST THE SITE AERIAL; BEARINGS AND DISTANCES ON THE DRAWING ARE GIS-DERIVED. RECORD BEARINGS, DISTANCES AND AREA PER PM 5062; SEE 'BOUNDARY & RECORD DATA'; DIMS IN FEET.
- AG AREAS AND STRUCTURE FOOTPRINTS AERIAL-DERIVED. FIELD-CORROBORATED, AND PER OWNER MEASUREMENT WHERE STATED (STORE 12'x10', STORAGE 10'x10', BARN 50'x44'). EACH CROP AREA IS DRAWN INSIDE THE PROPERTY LINES, CLEAR OF THE DRIVEWAY AND STRUCTURES, AND SCALES TO THE AREA TABULATED FOR IT — THE DRAWING AND THE TABLE AGREE. AG-3 STOPS AT THE FENCE — 20' W OF SEPTIC; AG-9 LEGS MEASURED 200' (W), 130' (N), 190' (E FENCE); W AND N SIDES CURVE OUT.
- NO GRADING OR NEW CONSTRUCTION PROPOSED; THE 12'x10' STORE IS AS-BUILT. PLAN DOCUMENTS EXISTING AG OPERATIONS + THE AS-BUILT SMALL AG. STORE (ZO §6157).
- SETBACKS PER ZO §4810 SCHEDULE C (DESIGNATOR C). FRONT YARDS 60'; FROM THE EAST P.L., AND 5 OF THE BEND FROM WHIRLWIND LN, 30' W OF THE WEST P.L. (60' ROAD; THE W P.L. IS ITS EAST EDGE). N OF THE BEND: EXTERIOR SIDE YARD, GREATER OF 33' FROM LN, OR THE 15' INT. SIDE YARD (PDS-306 P.5) — 15' OFF THE ESMT. N/S INTERIOR SIDE YARDS 15'; NO REAR YARD — LOT FRONTS STREETS E + W.
- THE AS-BUILT STORE SITS N OF THE WHIRLWIND BEND, CLEAR OF EVERY REQUIRED YARD (31' FROM THE ROAD EDGE, 61' FROM ITS E, 470' FROM THE EAST P.L.). EXIST. TINY HOME (W) IS TO BE REMOVED. WHIRLWIND LN IS APPROXIMATE PENDING PM 05062.
- POND IS RUNOFF-FED (NO PUMP); IRRIGATION SOURCE & AREA OF INUNDATION; LOT DRAINS TO POND, WELL, SEPTIC AND LEACH LINES PER OWNER, APPROXIMATE.
- THE GREENHOUSE AND TRELLIS GARDEN ARE OPEN AG STRUCTURES WITHIN THE CROP AREAS AND ARE TABULATED AS BUILDING AREA; THEIR GROUND IS COUNTED IN AG-7. ELECTRICAL: 400A MAIN PANEL AT THE NE COR. OF THE STORAGE BLDG.
- DRIVEWAY RUNS FROM THE STORE/PARKING YARD S BETWEEN AG-1 AND AG-4, E BETWEEN AG-4 AND THE BARN AND PAST THE RESIDENCE, THEN SE BETWEEN AG-9 AND AG-12, LEAVING THE PARCEL NEAR THE SE CORNER AND CONTINUING ±700' TO HANDLEBAR RD VIA AN ACCESS ESMT. ACROSS THE ADJACENT PARCEL. GRAVEL BOTH ENDS, DIRT MID-SEGMENT, 12' WIDE; SLOPE 2% DRAINING W. NO OTHER ROAD CROSSES THE PARCEL. ALIGNMENT TRACED FROM THE SITE AERIAL.
- WHIRLWIND LN IS A 60' ROAD. THE WEST P.L. IS ITS EAST EDGE, ON THE EXIST. WEST FENCE; ITS E IS 30' W OF THAT LINE (OWNER-MEASURED FENCE TO E = 30'). N OF THE BEND IT CROSSES THE NW CORNER, HANDLEBAR RD OFF-SITE (NOTE 8). PM 05062 TBD.
- NO NEW OR MODIFIED LANDSCAPE AREA PROPOSED (PDS 090 ITEM 16). EXISTING AG, PERIMETER AND POOL FENCING AND GATES ONLY; ALL ARE 6'-0" OR LESS IN HEIGHT PER OWNER — NO BLDG. PERMIT REQ'D PER PDS 070.
- THE SMALL AGRICULTURAL STORE IS THE AS-BUILT 'MINI BARN MARKET', A 12'x10' BUILDING, 110 SF INSIDE WALLS — WELL UNDER THE 1,500 SF LIMIT OF §6157.a.2 + INCL. OPEN ROOFED DISPLAY (NONE). THE ADJACENT 10'x10' BLDG IS STORAGE ONLY; NO OTHER STRUCTURE WILL BE USED FOR ON-SITE SALES. PUBLIC-ACCESSED AREAS TO BE PERMITTED TO COMM. BLDG. CODE AND DEHQ REQUIREMENTS.
- ACCESSIBLE STALL, AISLE AND THE ROUTE TO THE STORE ENTRANCE TO BE A STABLE, FIRM, SLIP-RESISTANT SURFACE PER CBC CH. 11B AND §6157.a.2.h.

AGRICULTURAL OPERATIONS & SMALL AGRICULTURAL STORE

PLOT PLAN — EXISTING CONDITIONS & AS-BUILT STORE

17054 HANDLEBAR RD, RAMONA, CA 92065

APN 278-361-08-00 · ZONE A70

SCALE: 1" = 40'

DATE: 8/06/2026

SHEET 1 OF 2 · REV 39


REV DATE DESCRIPTION

4-6 8/06-8/19 BASE, SETBACKS, FARM STORE

7-16 8/21/2026 OWNER CORRECTION ROUNDS

17-32 8/22-9/15 RECORD DATA, SETBACKS, AS-BUILT

33-39 9/15-9/16 WHIRLWIND; AG-6; §6156 AREAS

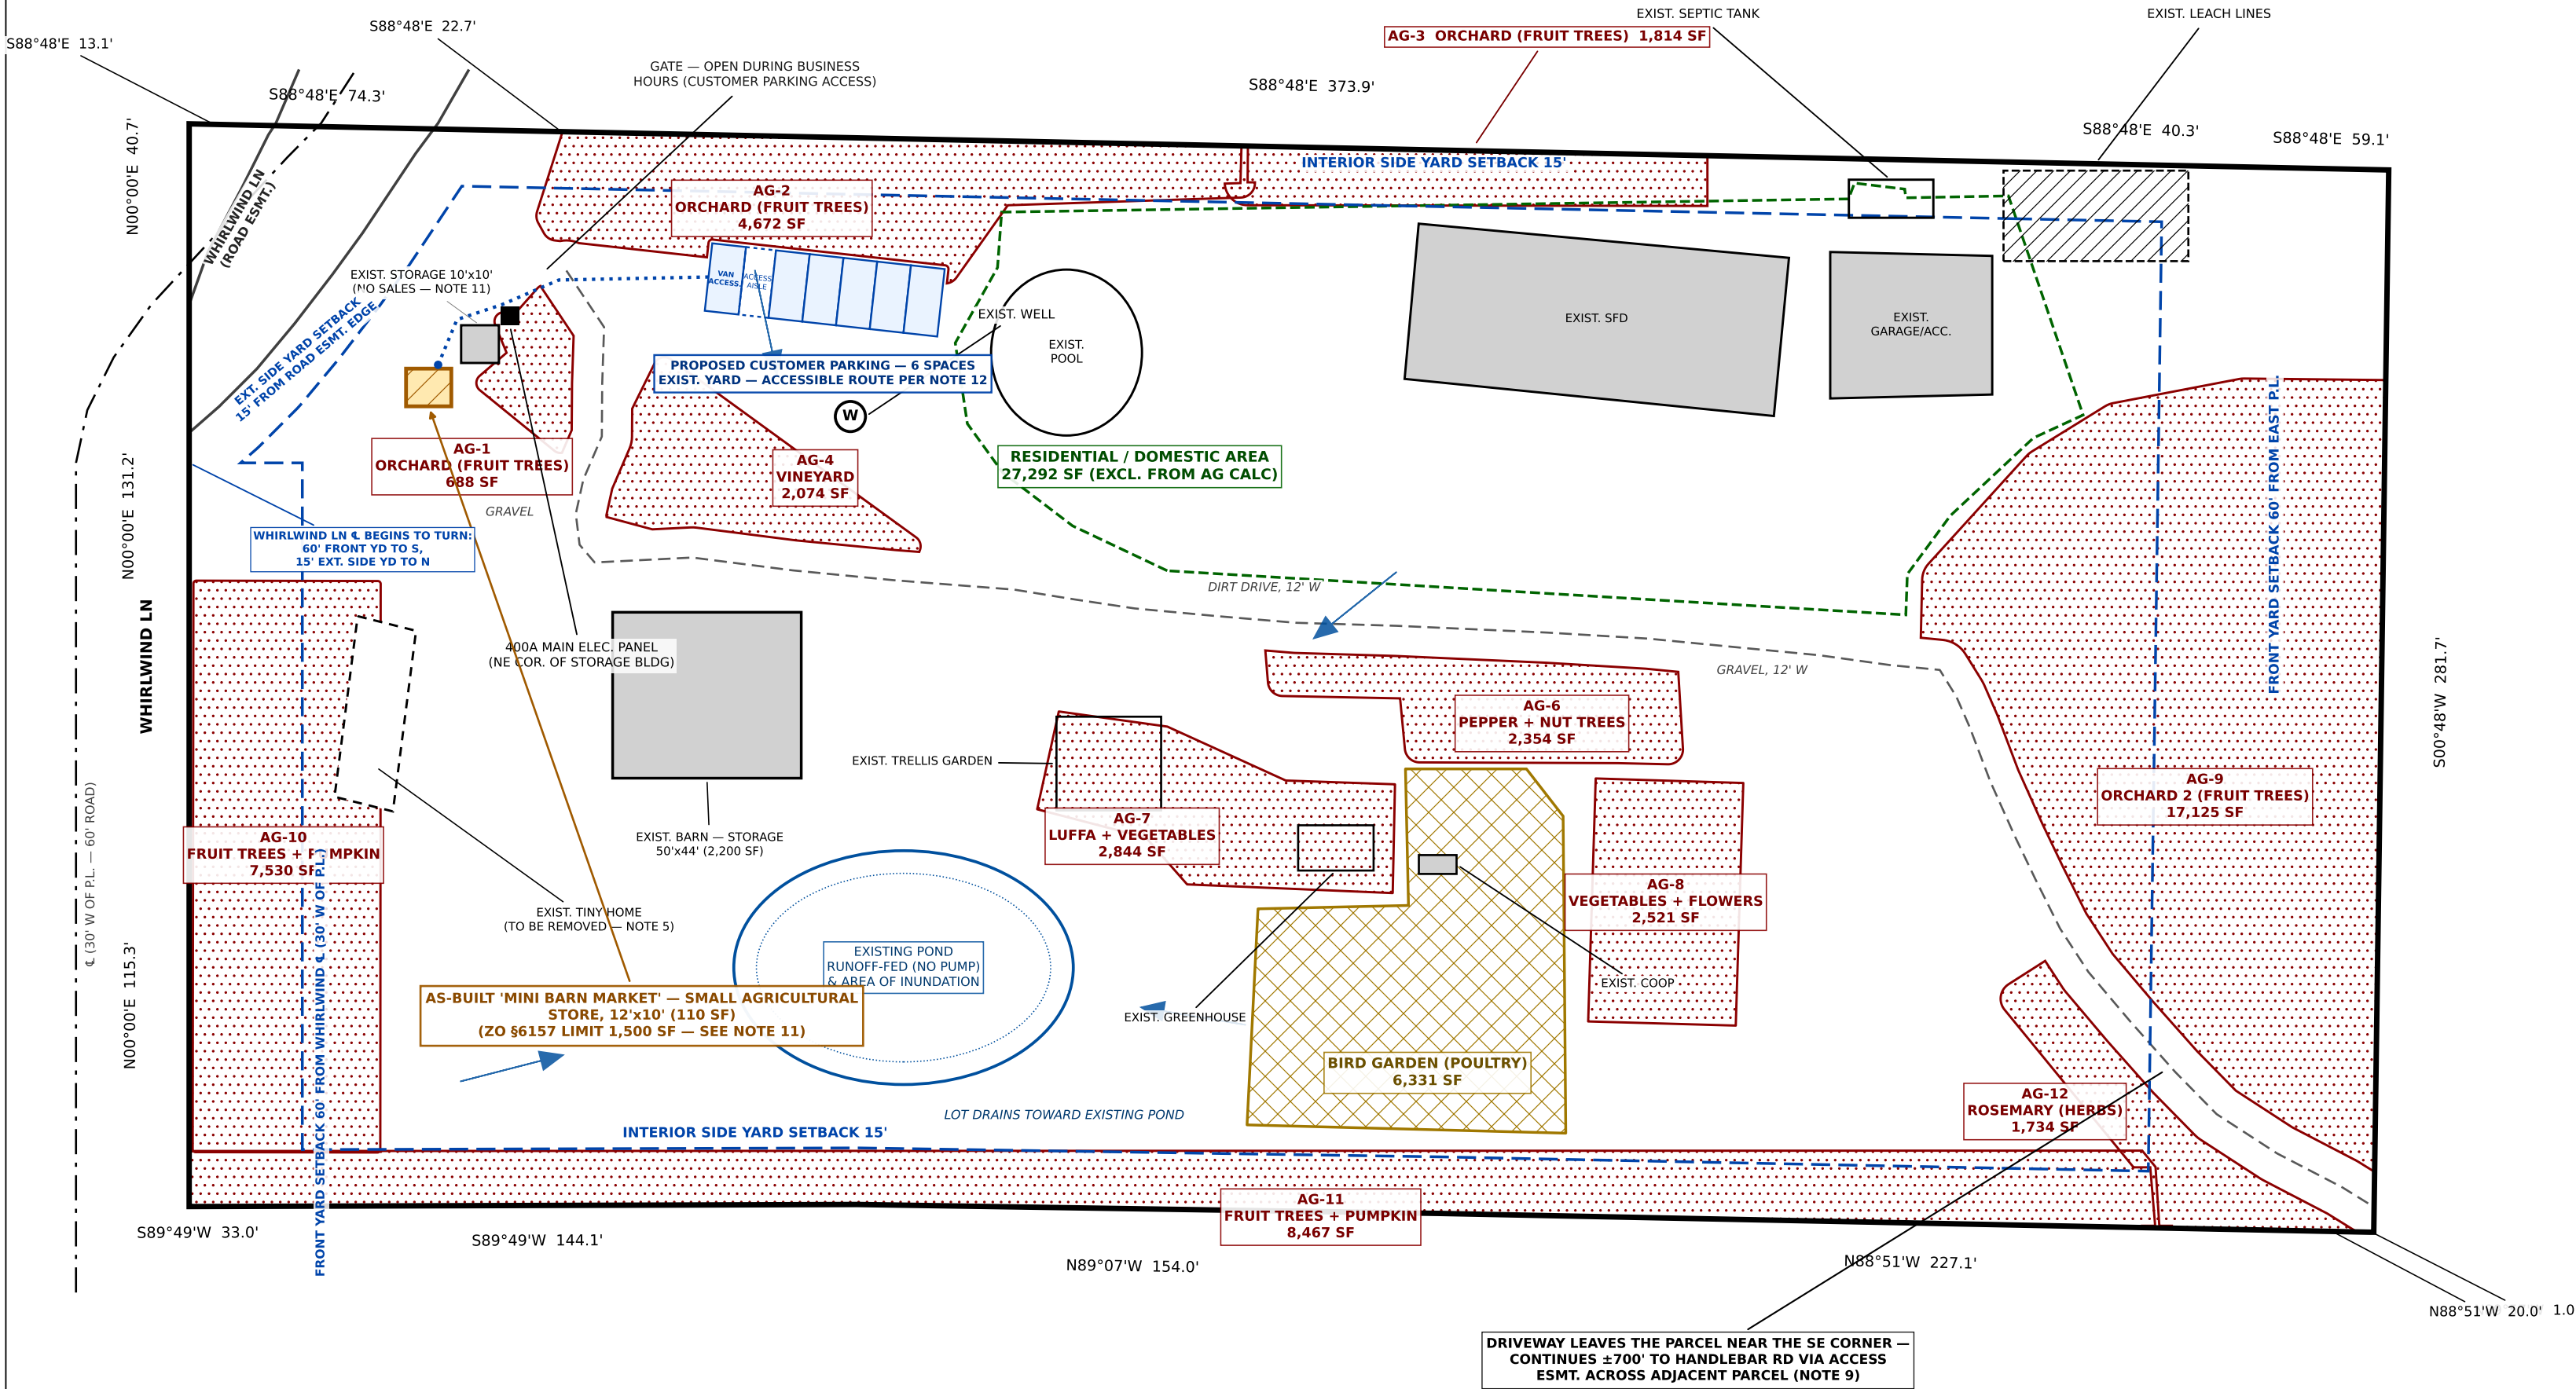

AGRICULTURAL USE CALCULATION

PER ZO §6157.a.2.b — GROSS BASIS

TOTAL GROSS AREA OF PREMISES 164,443 SF

b.i REQUIRED 50% SUITABLE / AVAILABLE 82,222 SF

PROVIDED (GROSS LESS RESIDENTIAL) 137,151 SF

= 83.4% OF GROSS PASSES

b.ii REQUIRED 25% IN ACTIVE AG USE 41,111 SF

CROP AREAS AG-1 THRU AG-12 51,823 SF

POULTRY (BIRD GARDEN) 6,331 SF

PROVIDED TOTAL ACTIVE AG USE 58,154 SF

= 35.4% OF GROSS PASSES

MARGIN OVER THE 25% REQUIREMENT +17,043 SF

BOTH ZO §6157.a.2.b THRESHOLDS ARE MET

NET AREA EXCL. ROAD ESMTS. (PDS 090 ITEM 12): 157,251 SF

ON THE NET BASIS AG USE IS 37.0% — MET EITHER WAY.

SMALL AGRICULTURAL STORE

COMPLIANCE — ZONING ORDINANCE §6157.a.2

(ZO UPDATE 102, PUBLISHED 3-26-2020)

§6157C	COMMERCIAL AG MUST BE THE PRINCIPAL USE	SEE b.i / b.ii
a	PERMITTED IN A70 USE REGS.	A70 — NO MIN. LOT SIZE
	NO ZONING VERIFICATION PERMIT REQ'D	PERMITTED BY RIGHT
b.i	≥50% OF GROSS SUITABLE/AVAILABLE	83.4% PROVIDED
b.ii	≥25% OF GROSS IN ACTIVE AG USE	35.4% PROVIDED
c	OPERATED BY OWNER OR TENANT	OWNER-OPERATED
d	ONE STORE PER LEGAL LOT; NO EXIST. AG STAND OR LARGE AG STORE	NONE EXISTING
e	STORE ≤1,500 SF INCL. ROOFED DISPLAY CONFORM TO §4810 SETBACKS	110 SF — COMPLIES STORE CLEARS ALL YARDS
	PUBLIC AREAS TO COMM. BLDG. CODE + DEHQ	SEE NOTE 11
f	RETAIL ONLY WITH ON-SITE PRODUCE / EGGS; AG WEIGHTS & MEASURES REGS. APPLY	ACKNOWLEDGED
g	≤200 SF FOR OFF-SITE PRODUCTS	TO BE DESIGNATED
h	MINIMUM 6 PARKING SPACES	6 SHOWN, GRAVEL
	DISABLED ACCESS PER CBC CH. 11B	1 VAN ACCESSIBLE
i	HOURS 10 A.M. TO LEGAL SUNSET	ACKNOWLEDGED
j	ONE ON-PREMISE SIGN, MAX 4 SF	ACKNOWLEDGED
k	EVENTS PROHIBITED	ACKNOWLEDGED

STORE AREA SUMMARY

STORE = AS-BUILT 'MINI BARN MARKET' BLDG 12'x10'	110 SF
OPEN ROOFED DISPLAY AREA	0 SF
TOTAL PER §6157.a.2.e — LIMIT 1,500 SF	110 SF

PARKING — ZO §6157.a.2.h

REQUIRED	6 SPACES
PROVIDED	6 SPACES
STANDARD 9' x 18'	5
VAN ACCESSIBLE 9' x 18' + 8' AISLE	1
SURFACE — GRAVEL (EXPRESSLY ALLOWED)	EXISTING

THE STORE IS THE AS-BUILT 12'x10' MINI BARN MARKET BUILDING —

110 SF AGAINST A 1,500 SF LIMIT. THE ADJACENT 10'x10'

BUILDING IS STORAGE ONLY — NO SALES.

LEGEND

	AS-BUILT STORE ('MINI BARN MARKET' 12'x10')
	PROPOSED CUSTOMER PARKING
	AGRICULTURAL CROP AREA
	POULTRY AREA (BIRD GARDEN)
	RESIDENTIAL / DOMESTIC AREA
	EXISTING STRUCTURE
	STRUCTURE TO BE REMOVED
	LEACH LINES
	ROAD CENTERLINE
	ROAD EASEMENT LINE
	REQUIRED YARD SETBACK
	DRIVEWAY CENTERLINE
	DIRECTION OF LOT DRAINAGE
	EXISTING WELL

STORMWATER (PDS 272)


NO GRADING OR CLEARING PROPOSED. THE AS-BUILT 12'x10' STORE (110 SF) IS THE ONLY ADDED IMPERVIOUS AREA; UNDER PERMIT THRESHOLDS.

SD-B: RUNOFF DIRECTED TO PVIOUS/LANDSCAPED AREAS.

SD-G: EXISTING NATURAL SWALES AND POND CONSERVED.

SD-H: VEGETATED BUFFER MAINTAINED AROUND EXISTING POND.

VICINITY MAP

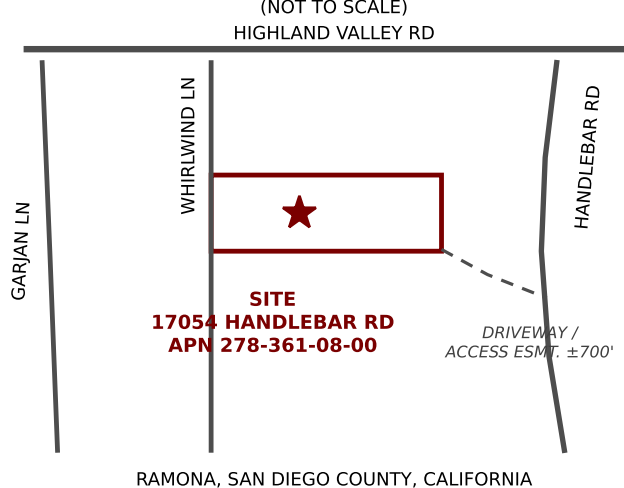

BOUNDARY & RECORD DATA

LEGAL: PARCEL 1 OF PARCEL MAP NO. 5062

ASSESSOR'S MAP BK 278, PG 36, SHT 1, PARCEL 8

COURSE	RECORD PER PM 5062	MEASURED (GIS)
NORTH	N89°32'W 550.50'	S88°48'E 583.25'
EAST	N00°43'E 285.58'	S00°48'W 281.71'
SOUTH	N89°32'W 550.50'	N89°20'W 579.19'
WEST	N00°43'E 285.58'	N00°00'E 287.11'

AREA RECONCILIATION

RECORD 550.50' x 285.58' 157,212 SF (3.61 AC)
ASSESSOR'S NET AREA (PDS 090 ITEM 12) 157,251 SF (3.61 AC)
COUNTY GIS POLYGON — AREA DRAWN 164,443 SF (3.78 AC)
DIFFERENCE (GIS LESS RECORD) 7,231 SF

THE GIS POLYGON IS 32.75' WIDER E-W THAN RECORD; THAT STRIP IS THE 30' ROAD ESMT. ALONG THE WEST BOUNDARY — I.E. THE COUNTY'S OWN GROSS / NET SPLIT.

ZO §6157 TESTS ARE APPLIED TO THE LARGEST (GROSS) AREA — THE MOST CONSERVATIVE BASIS. THE PARCEL PASSES ON GROSS (35.1%) AND ON THE RECORD PARCEL (36.7%).

BASIS OF BEARINGS: GRID BEARINGS, NAD83 CALIFORNIA STATE PLANE ZONE 6, PER COUNTY GIS. RECORD BEARINGS AND DISTANCES PER PM 5062 / ASSESSOR'S MAP AS TABLED ABOVE.

ADJOINING PARCELS: EAST — APN 278-361-10-00. SOUTH — APN 278-361-06/07/09-00. WEST — WHIRLWIND LN, THEN APN 278-361-02/03/04-00. NORTH — ASSESSOR'S BK 277, PG 12.